


LEGEND

Description	Quantity
Existing Compliant Access Stair	4
Existing Compliant Guardrail System	5
Existing Compliant Guardrail System	12
Existing Compliant Ladder System	5
Existing Compliant Portable Ladder Support Bracket	3
Existing Compliant Static Line	9
Existing Compliant Strop	3
Existing Compliant Top Mount Anchor Point	13
Existing Non-Compliant Aluminium Walkway System	13
Existing Non-Compliant Entry Kit	1
Existing Non-Compliant Ladder System	1
Existing Non-Compliant Portable Ladder Support Bracket	1
Existing Non-Compliant Static Line	1

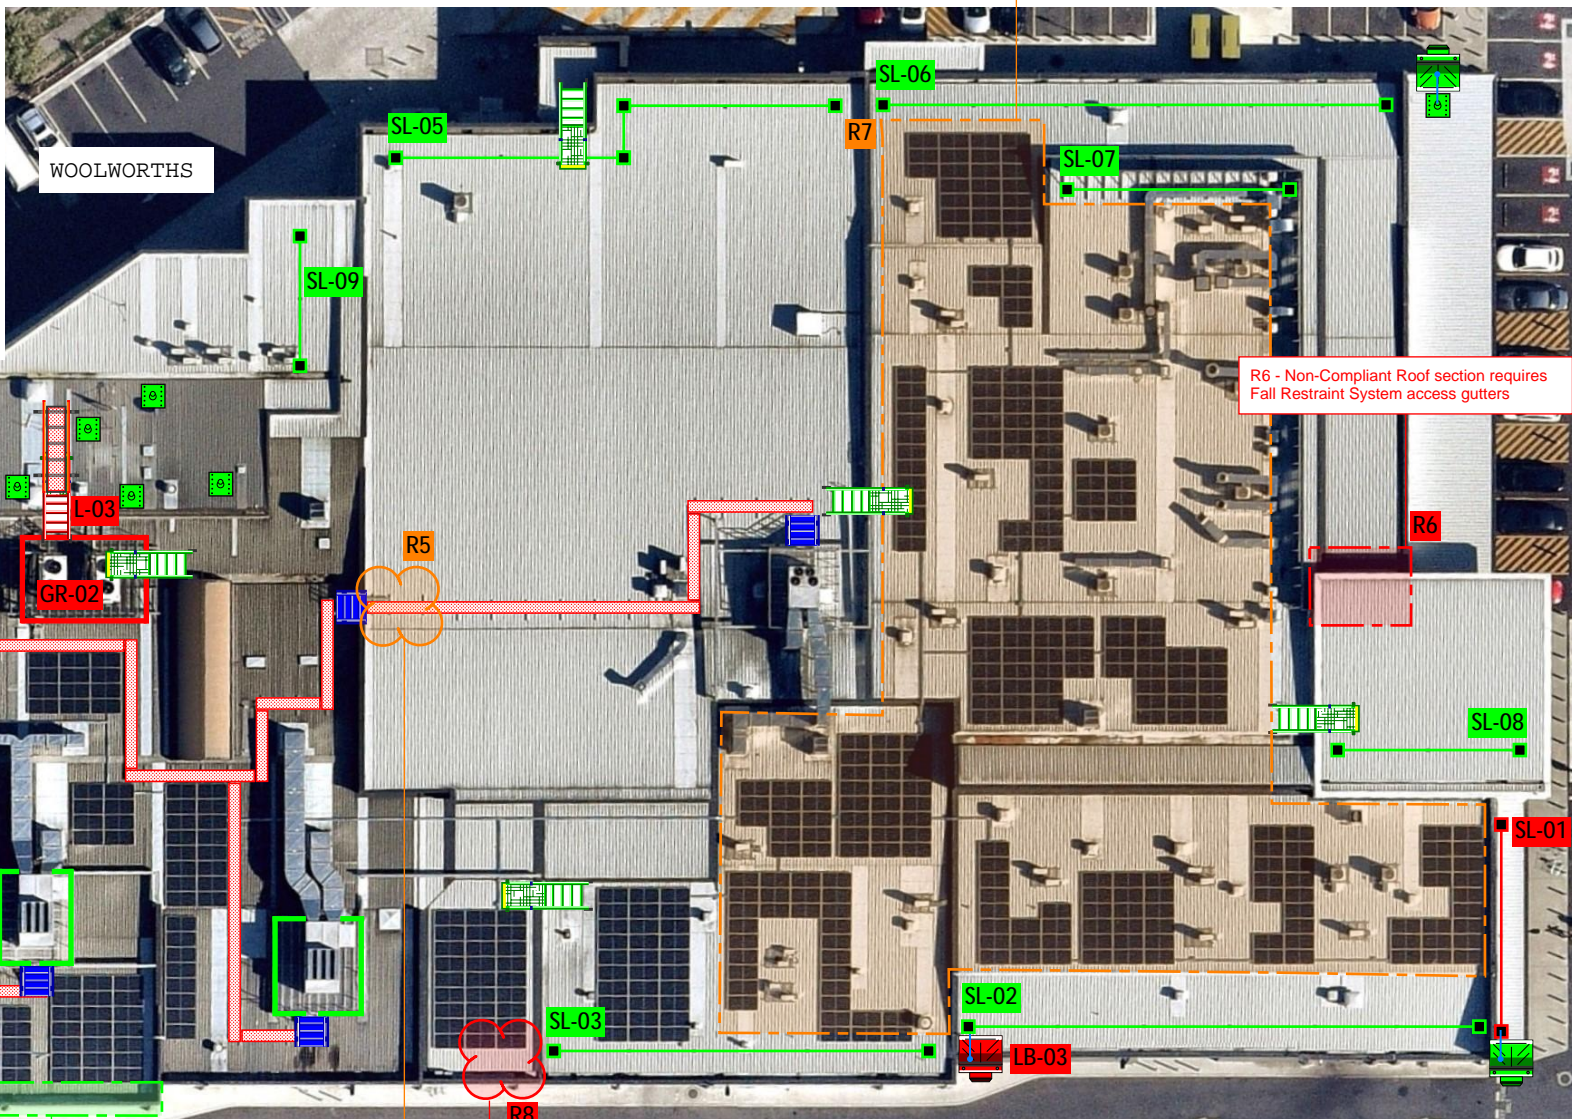

R7 - Walkway required to provide ease of access to all AC Units & Solar Panels requiring maintenance

R1 - Non-Compliant Roof Section requires Fall Restraint Access System

R6 - Non-Compliant Roof section requires Fall Restraint System access gutters

R2 - Non-Compliant Roof section requires additional Anchor Points to eliminate fall hazard

R3 - Parapet Crossover System required to provide Compliant Access, 1500x600mm

R4 - Parapet Crossover System required to provide Compliant Access, 1000x500mm

Parapet Wall over 900mm, no fall restraint System required here

R5 - Guardrail to be at 2m in length at both sides of entry required for Compliant Access

R8 - Additional Anchor Point required for compliant access to Gutter

<p>ISSUE:</p> <p>AS-BUILT</p> <p>27/09/2021</p> <p>AnchorSafe Projects</p>	<p>BY: DZ</p>	<p>APPROVED: DG</p>		<p>CLIENT:</p> <p>EXAMPLE AS-BUILT</p>	<p>TITLE:</p> <p>EXAMPLE AS-BUILT SITE INSPECTION & AUDIT OF EXISTING HEIGHT SAFETY SYSTEM SECTION 1</p>	<p>Quote No:</p> <p>-</p>
	<p>DRAWN: ANCHORSAFE</p>	<p>CHECKED:</p>		<p>SCALE:</p>		<p>Job No:</p> <p>-</p>
						<p>Quote No:</p> <p>-</p>